



REVISION HISTORY		
REV.	DESCRIPTION	DATE
A	INITIAL RELEASE	4-1-96
B	TOLS. +/- 0.010 O'ALL. FIXED DIM ON OVAL	5-14-96
C	MODELED IN SW. AS BUILT, PER CR# 1292	2003-01-08


- NOTES:
1. MAKE DRAIN HOLES SYMMETRICAL.
 2. DRAIN HOLES LOCATED ON LEFT AND BOTTOM SIDES ONLY.
 3. TOLERANCES ARE +/- 0.050 UNLESS OTHERWISE NOTED IN DRAWING OR MODEL.
 4. DIMENSIONS IN INCHES.

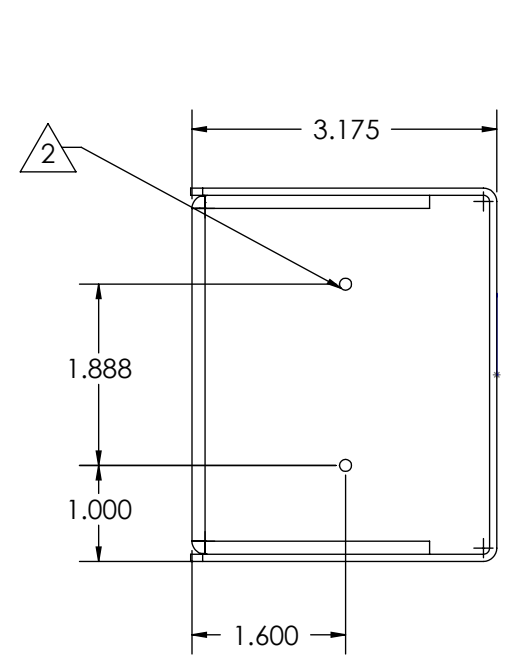


LEFT VIEW

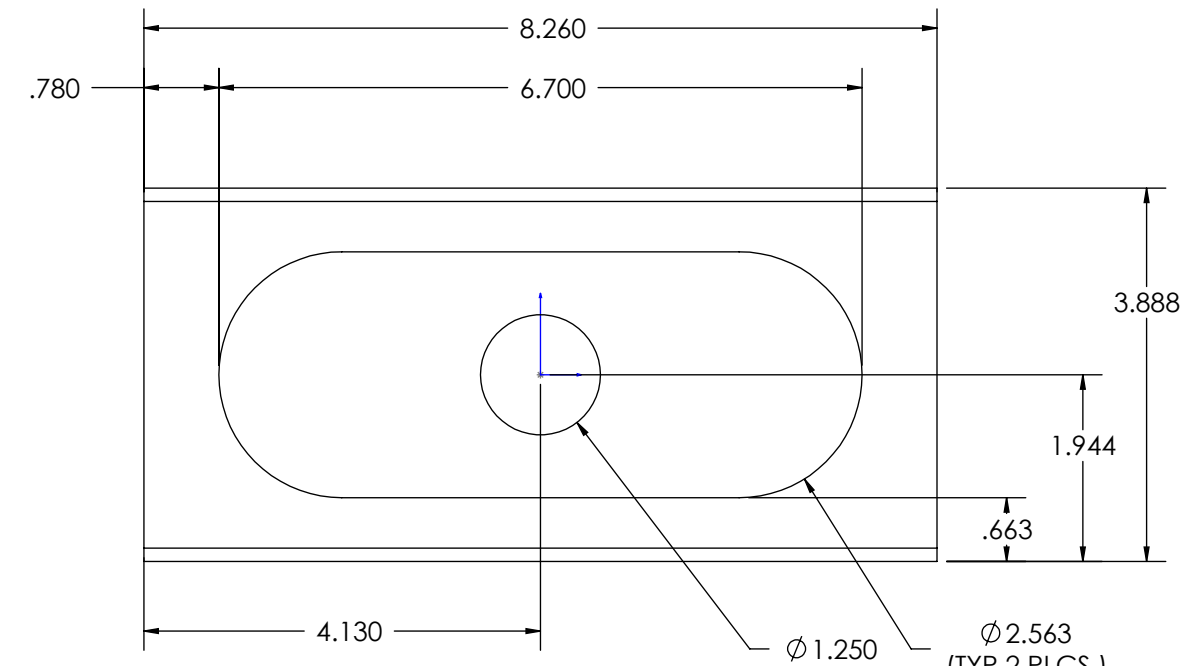

FRONT VIEW

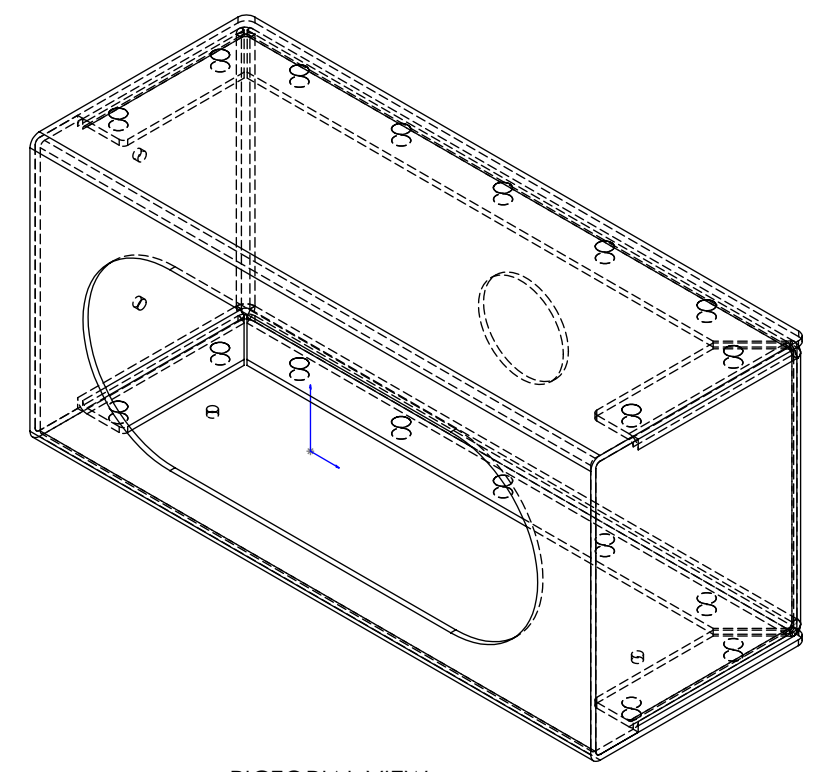

PICTORIAL VIEW

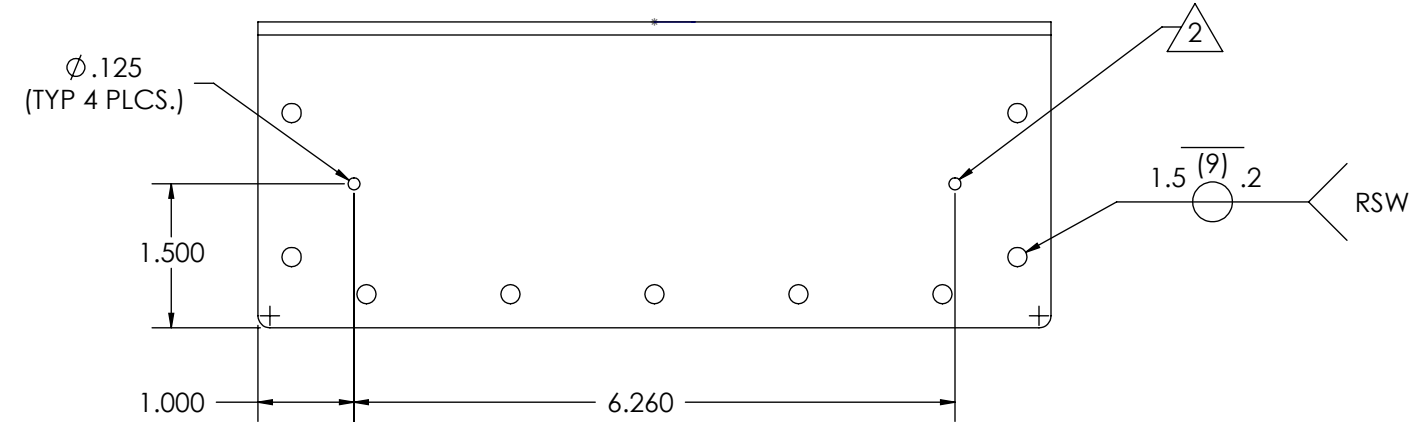

BOTTOM VIEW

STEEL, 14GA. (0.0747)		BLACK POWDER COAT	
MATERIAL		COLOR	
STEEL, 14GA. (0.0747)		MASS (LBS)	PART VOLUME (IN3)
		2.78	9.84

CAD GENERATED DRAWING DO NOT MANUALLY UPDATE. MODEL REFERENCED: C		DESIGNER	SNS	DATE	
DIMENSIONING AND TOLERANCING IN ACCORDANCE WITH ASME Y14.5M-1994 UNLESS OTHERWISE SPECIFIED TOLERANCES ARE IN INCHES. TOLERANCES ARE:		CHECKED			
FRACTIONS ± 1/64	DECIMALS X ± .1 .XX ± .01 .XXX ± .005 .XXXX ± .0030	MECH. ENG.			
THIRD ANGLE PROJECTION		ELEC. ENG.			
		MFG. ENG.			
		MATERIALS			

ECCO Electronic Controls Co. <i>An Employee Owned Company</i> 800-635-5900 P.O. BOX 7246, BOISE, ID 83707	
MOUNTING MODULE, OVAL REMOTE HEAD	
Project: CR-1292	Date Created: 4-1-96
SIZE B	DWG. NO. A9895
SCALE 1:2	PREPARED PER ASME 14.100M-1998 / ASME Y14.1-1995
SHEET 1 OF 1	

NON DISCLOSURE AGREEMENT
 THIS DRAWING AND THE DESIGN IT DISCLOSES ARE THE PRIVATE PROPERTY OF ECCO AND IS ISSUED IN CONFIDENCE FOR ENGINEERING INFORMATION ONLY. THE DRAWING AND / OR DESIGN MAY NOT BE USED, COPIED, REPRODUCED, OR OTHERWISE DISCLOSED IN PART OR AS A WHOLE TO OUTSIDERS OR USED FOR ANY OTHER PURPOSE WITHOUT THE PRIOR WRITTEN CONSENT OF ECCO. THE DRAWING IS SUBJECT TO RECALL AT ANY TIME. YOUR POSSESSION OF THIS DOCUMENT CONSTITUTES ACCEPTANCE OF THESE TERMS. © 2002 ECCO

